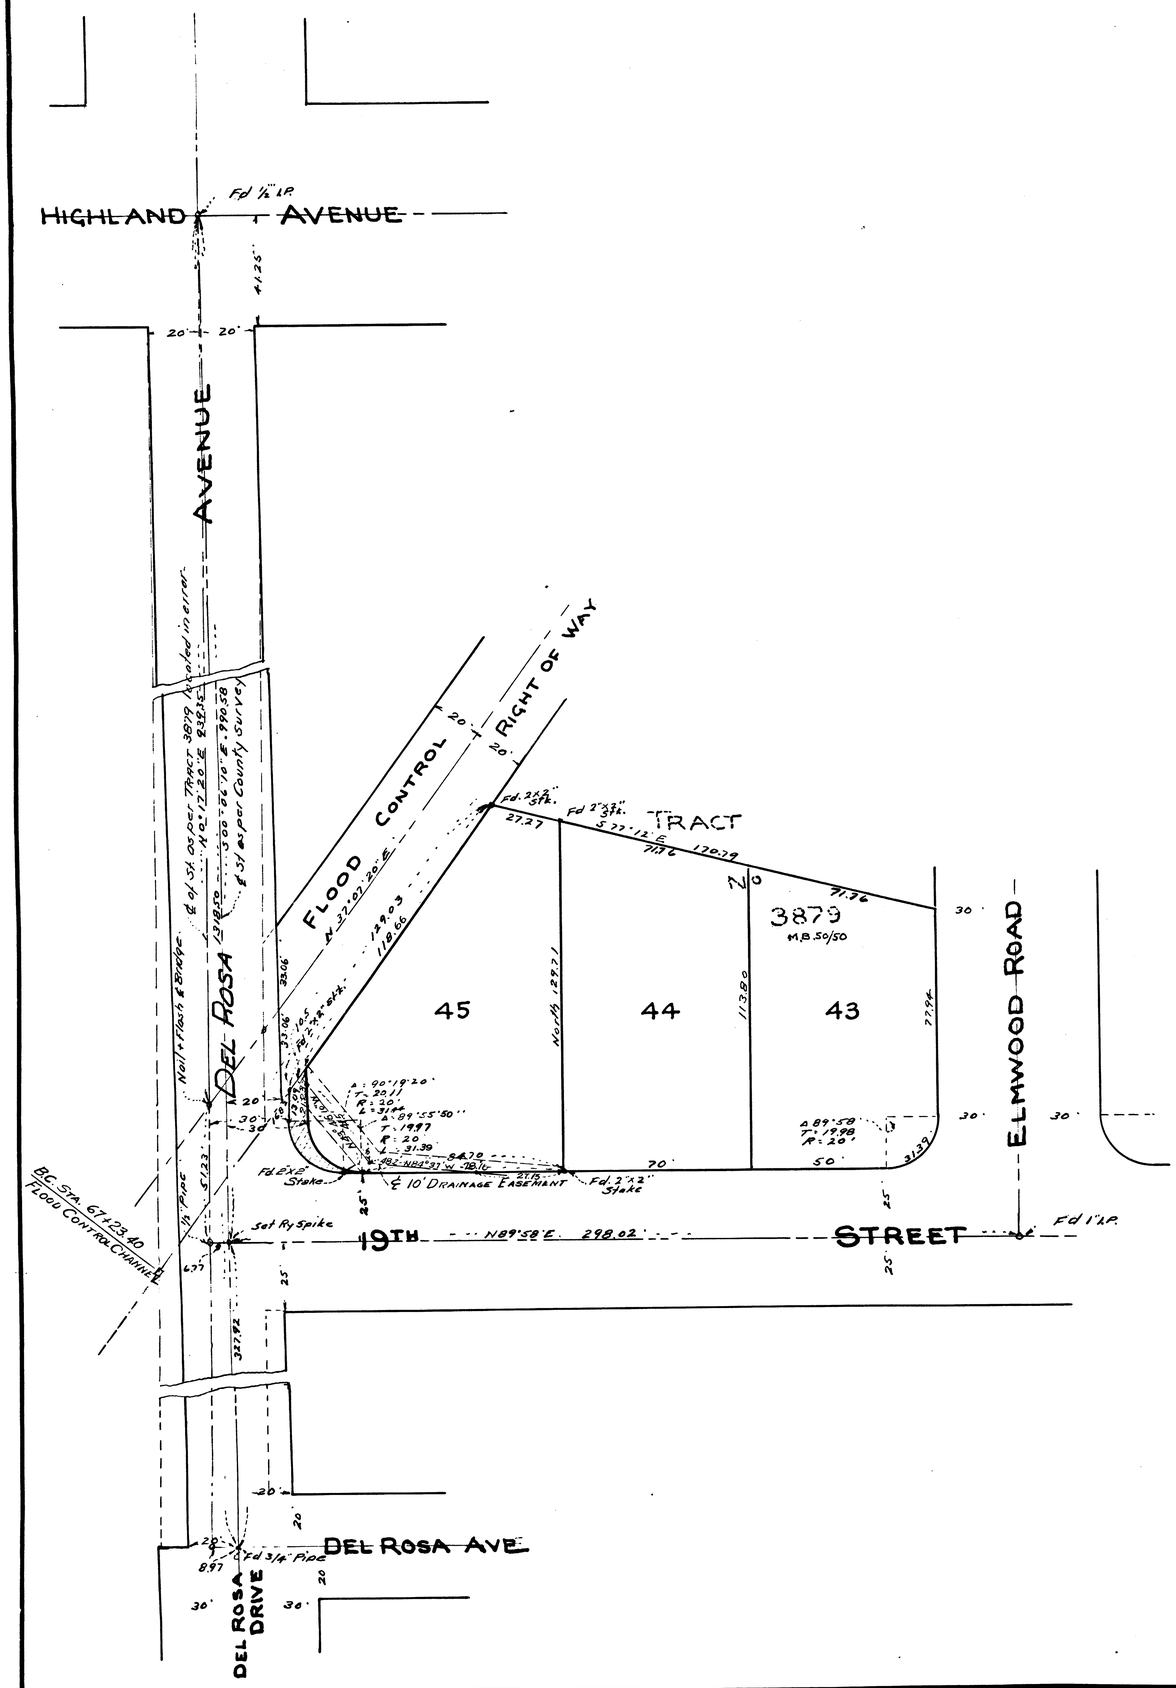

RECORD SURVEY

OF A PORTION OF TRACT Nº 3879 AS RECORDED IN BOOK 50 OF MAPS PAGE 50 RECORDS OF SAN BERNARDINO COUNTY CALIFORNIA

SAN BERNARDINO COUNTY
CALIFORNIA

Scale 1 IN. 40 FT.

Person requesting this Survey GORDON FIELDS

ENGINEERS CERTIFICATE

I C.E. JOHNSON do hereby Certify that I am a Registered civil engineer of the State of California and that this map consisting of one sheet correctly represents a survey made under my supervision in January 1953 and that all the monuments shown thereon actually exist and their positions are correctly shown. This survey was made to show corrected center line of Del Rosa Avenue and its ties to TRACT 3879

Dated this 20th day of April 1953

C.E. Johnson R.C.E. 2479

Note
Basis of Bearings TRACT Nº 3879
Set 2"x2" Rdw. stakes at all lot corners unless otherwise shown
Shaded Portion Lot 45 Deeded to County for highway purposes

COUNTY SURVEYOR'S CERTIFICATE

Map examined April 23, 1953
LEONARD P. WIKOFF County Surveyor
San Bernardino County California
By J. M. Moore
Deputy

440

Recorded at Request of County Surveyor
Date Apr. 23, 1953
at 3:04 P.M.
in Book 10 of R.S.
Page 7
Records San Bernardino County
TED R. CARPENTER
County Recorder
By L. L. Sturwood
Deputy Recorder
Fee $1.00