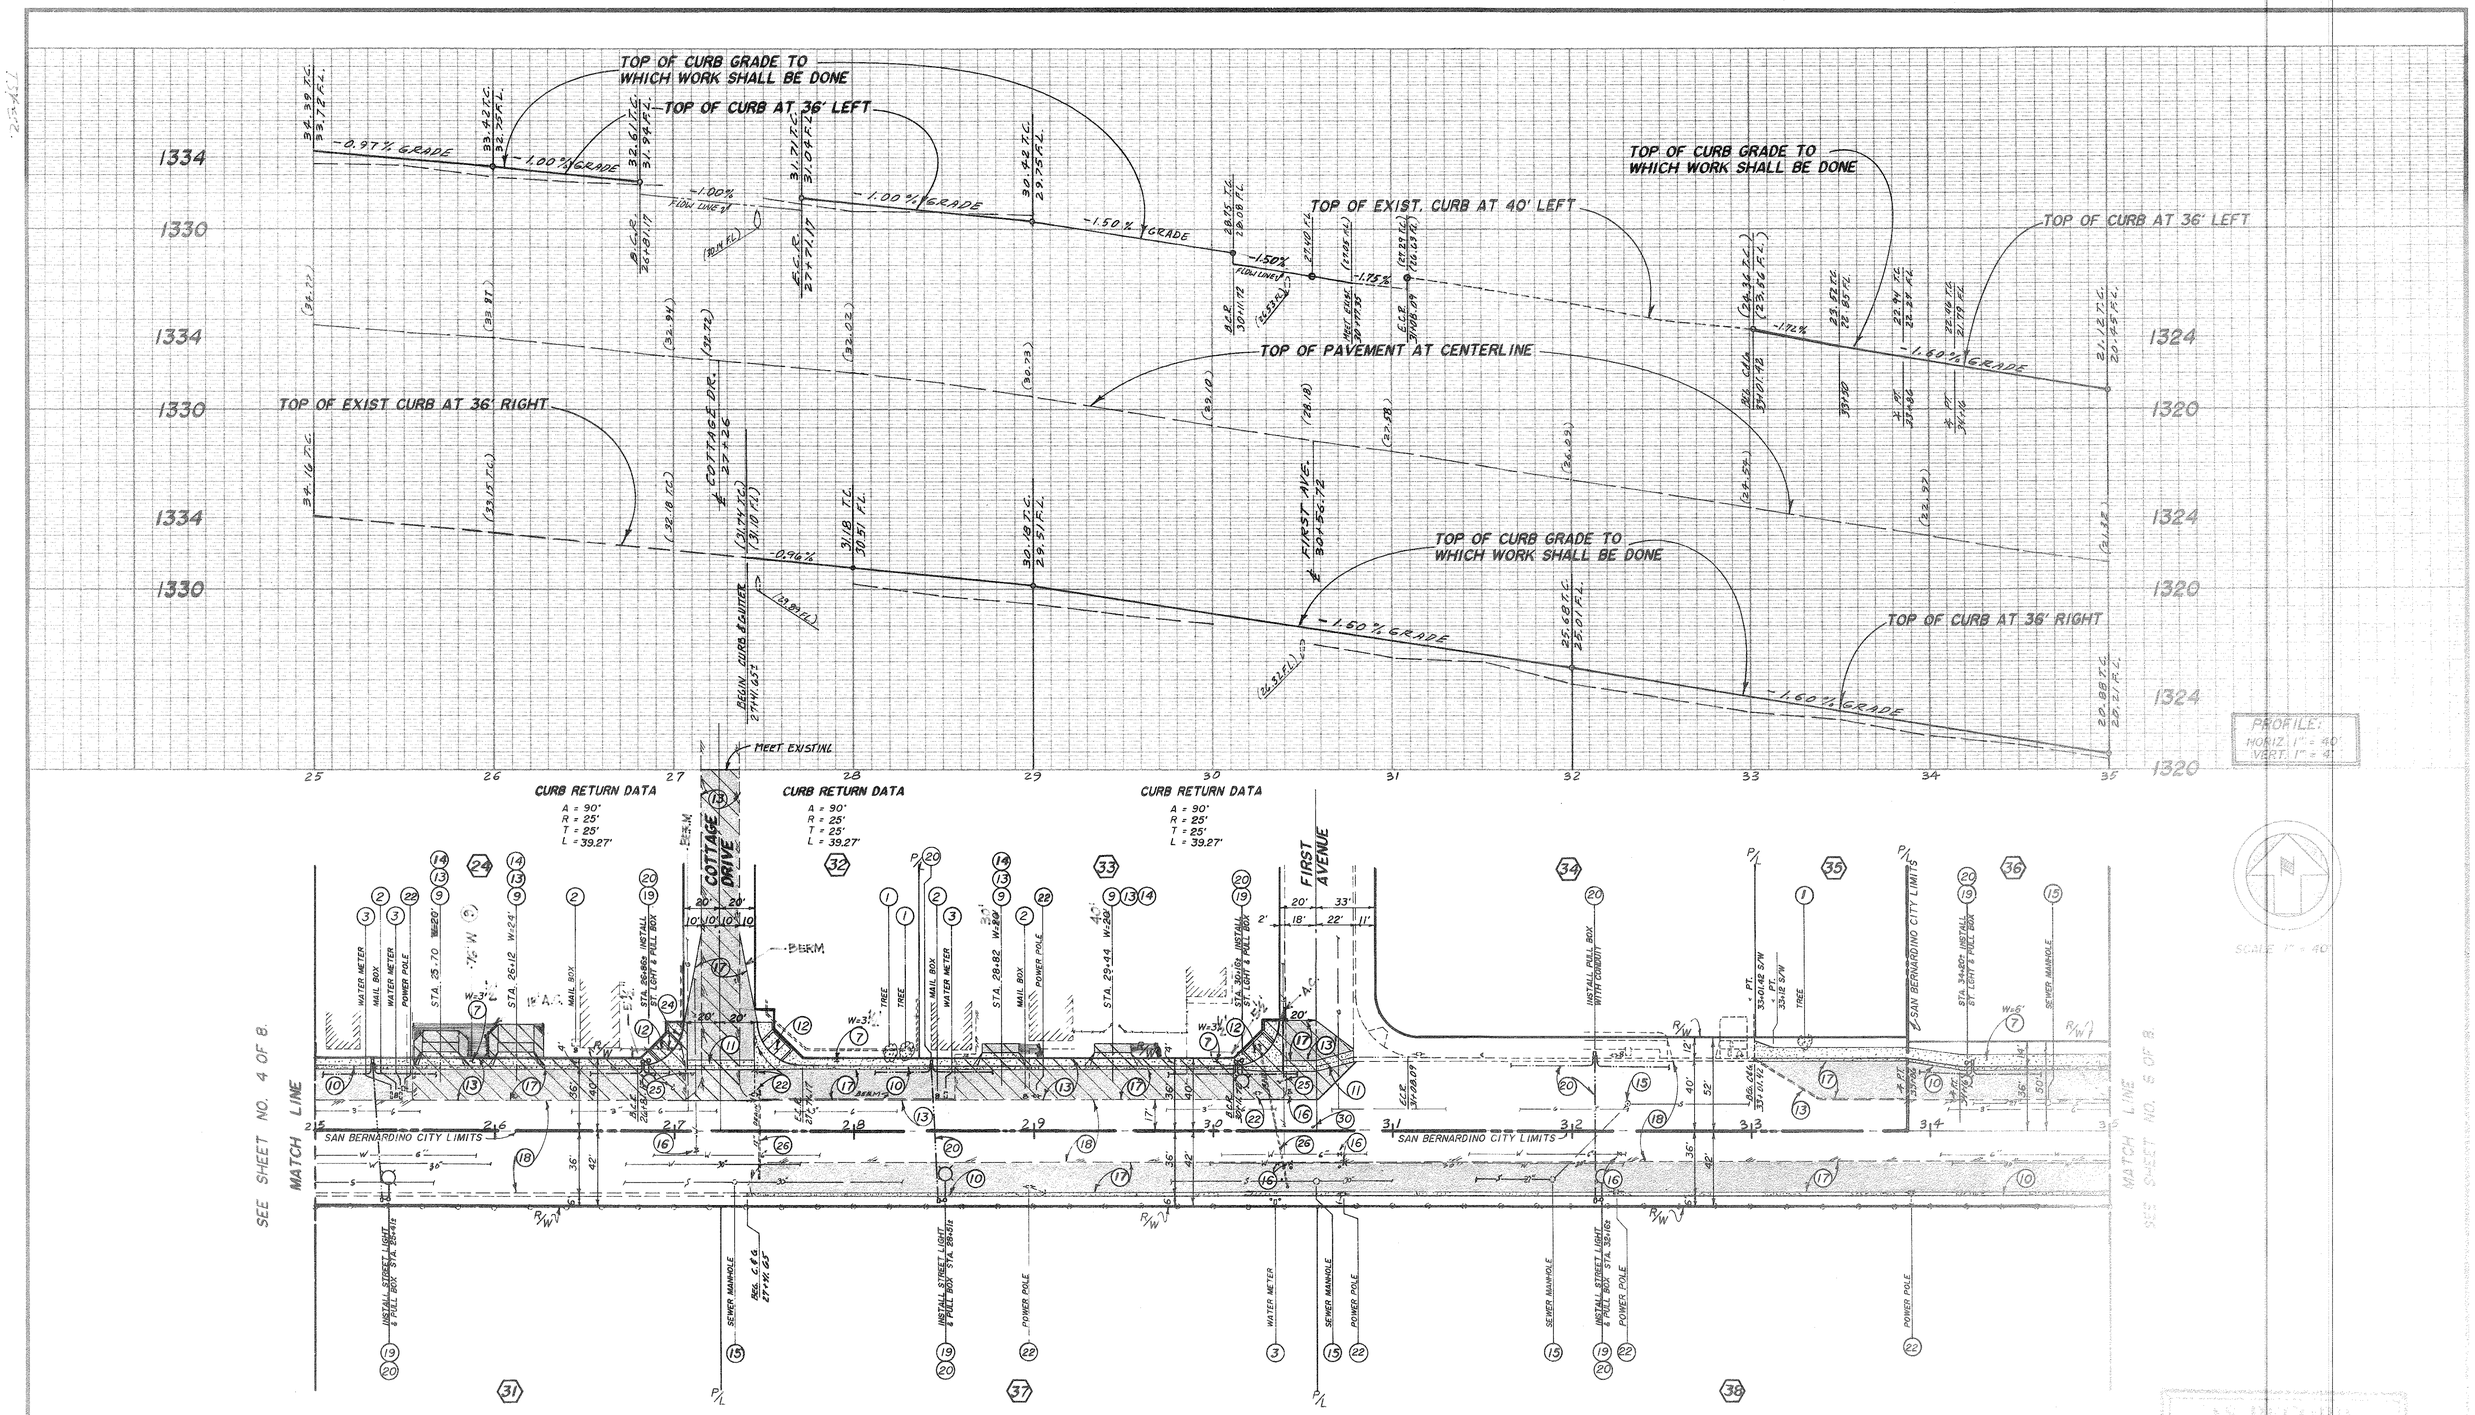

APPROVED _____ 19 96

DIRECTOR OF PUBLIC WORKS/CITY ENGINEER
REGISTERED CIVIL ENGINEER NO. 23014

MARK	REVISIONS	BY	APPR.	DATE
1	PER AS BUILT	R.A.		

DRAWN BY: R. Juarez & R. Sepulveda
CHECKED BY:
RECOMMENDED BY:

CITY OF SAN BERNARDINO
DEPARTMENT OF PUBLIC WORKS
STREET ENGINEERING
FORTIETH STREET
THIRD STATION
File no.