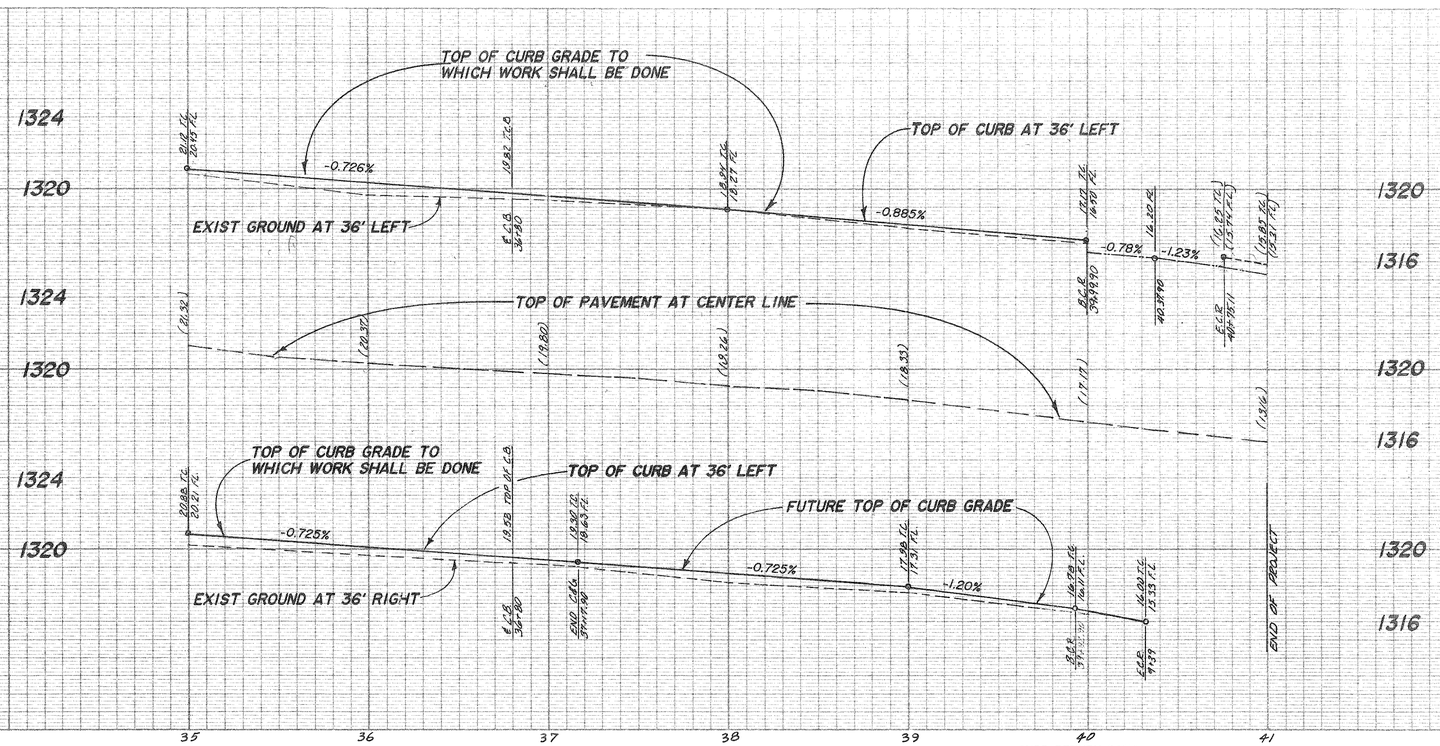

PROFILE:
HORIZ. 1" = 40'
VERT. 1" = 4'

CURB RETURN DATA
A = 90°
R = 20'
T = 20'
L = 31.40'

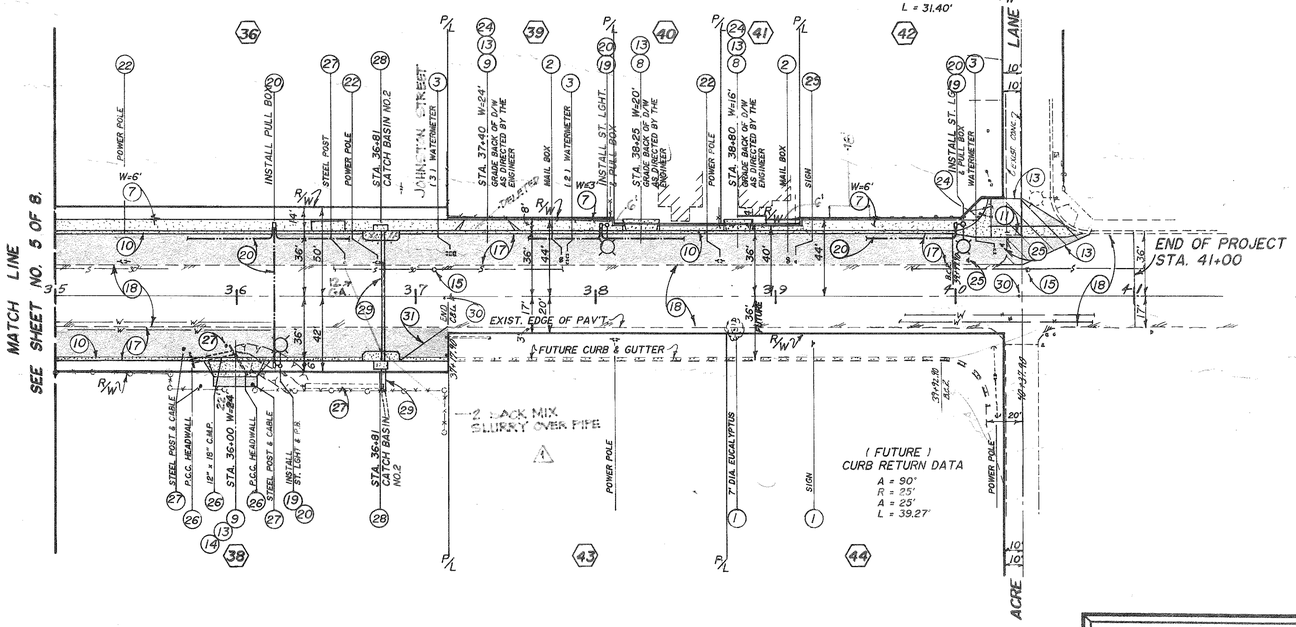

(FUTURE) CURB RETURN DATA
A = 90°
R = 25'
A = 25'
L = 39.27'

SCALE: 1" = 40'

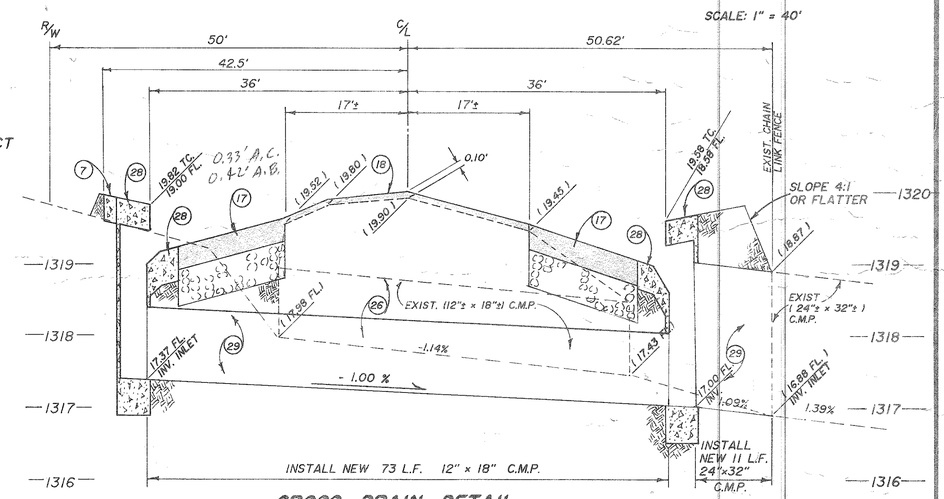

CROSS DRAIN DETAIL

STA. 36+80 SCALE: HORIZ. 1" = 10'
VERT. 1" = 1'

AS RECORD
NO NOTED DEVIATIONS FROM PLANS
APPROVED DATE 12/28/2001

MARK	REVISIONS	BY	APPR.	DATE
1	PER AS BUILT	F.G.		

APPROVED _____ 19 97
DIRECTOR OF PUBLIC WORKS/CITY ENGINEER
REGISTERED CIVIL ENGINEER NO. 23014

DRAWN BY: R. Juarez & R. Sepulveda
CHECKED BY:
RECOMMENDED BY:

CITY OF SAN BERNARDINO
DEPARTMENT OF PUBLIC WORKS

STREET WIDENING
FOR
FORTIETH STREET
THIRD AVE. TO ACRE LN.
STATION 35+00 TO 41+00

DRAWING NO. 9460
SHEET 6 OF 8 SHEETS

File no. C.I. no. 1256 W.O. no. 7008